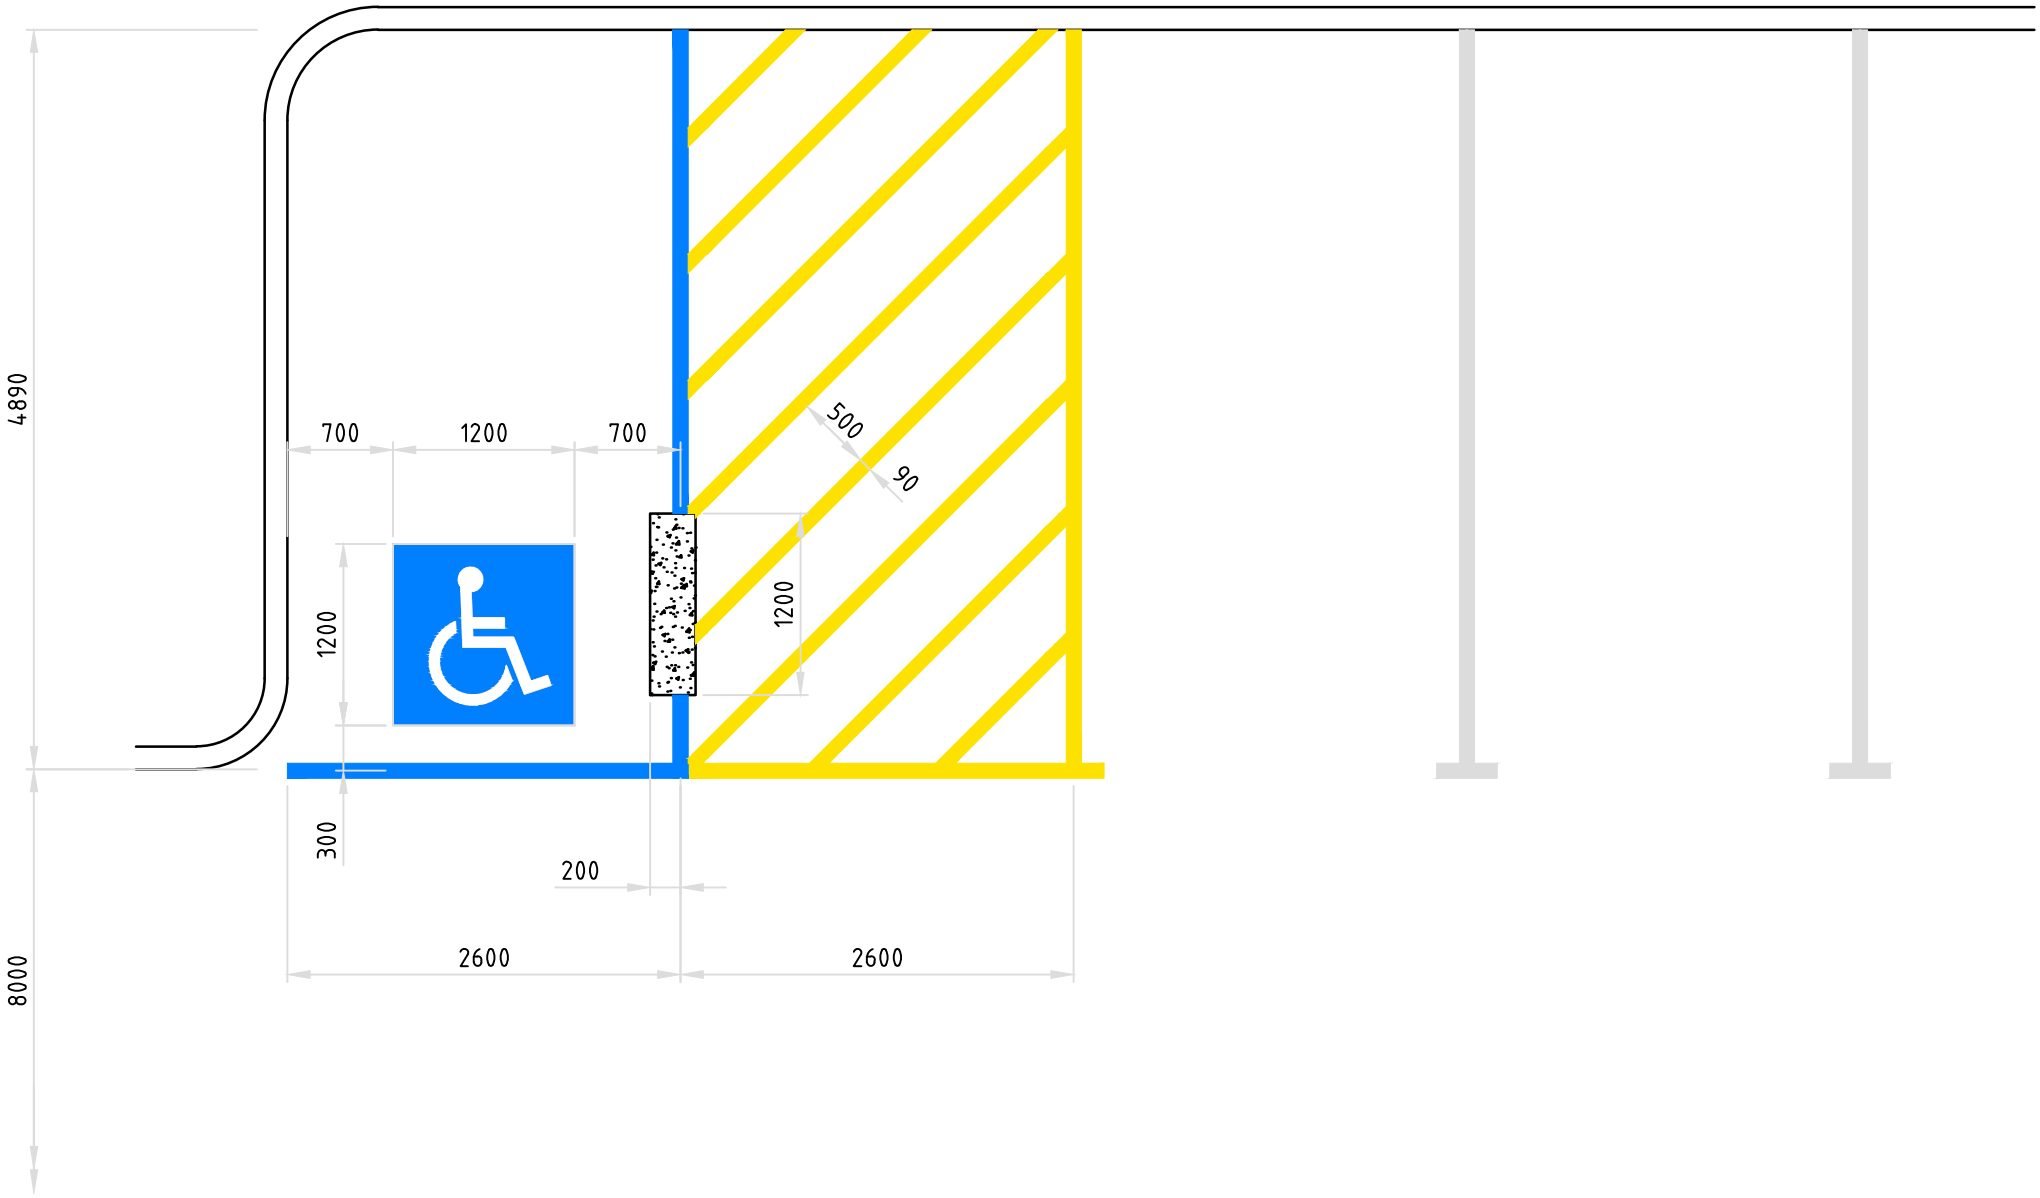

HEAD HEIGHT = 3000